

INDEX

Description	Mile Post	Structure No.	Dwg. No.
Little Elk Creek Br. No. 1	25.10	18046	55323
Little Elk Creek Br. No. 2	25.20	18047	55336
Work Access Br. No. 2A	25.20	2A	—
Little Elk Creek Br. No. 3	25.30	18048	55356
Little Elk Creek Br. No. 4	25.44	18049	55368
Work Access Br. No. 4A	25.44	4A	—
Little Elk Creek Br. No. 5	25.75	18050	55382
Little Elk Creek Br. No. 6	26.20	18051	55396
Work Access Br. No. 6A	26.20	6A	—
Little Elk Creek Br. No. 7	26.70	18052	55409

INDEX

Description	Mile Post	Structure No.	Dwg. No.
Work Access Br. No. 7A	26.70	7A	—
Little Elk Creek Br. No. 8	26.82	18053	55428
Little Elk Creek Br. No. 9	27.10	18054	55447
Little Elk Creek Br. No. 10	27.70	18055	55465
Work Access Br. No. 10A	27.70	10A	—
Retaining Wall @ 42+270	25.93	18212	55480
Retaining Wall @ 44+700	27.44	18213	55482
Wakefield Creek Culvert	27.91	18057	55484
Austin Creek Culvert	28.58	18056	55487

* 4559, 4586, 4588-4591

NOTE: All stations and elevations are in meters. All other dimensions are in millimeters (mm) except as noted.



DATE	REVISION	BY
10-16-07	As Constructed	JAM

DRAFTED: Richard G. Olson Richard G. Olson
CHECKED:
REVIEWED:

BRIDGE ENGINEER

EXPIRES: 6/30/98

OREGON DEPARTMENT OF TRANSPORTATION
BRIDGE ENGINEERING SECTION

ACCOMPANIED BY DWGS. 55323-55489, BR145, BR200

BRIDGE NO. See Above
DATE 08-JUL-1997
CALC. BOOK *


LITTLE ELK CREEK BRIDGES
EDDYVILLE-CLINE HILL SECTION
CORVALLIS-NEWPORT HWY. (NO. 33)
LINCOLN COUNTY

GENERAL PLAN

FEDERAL HIGHWAY ADMINISTRATION
REGION 10 OREGON DIVISION

PROJECT NUMBER

SHEET 1 OF 1
DRAWING NO. 55322

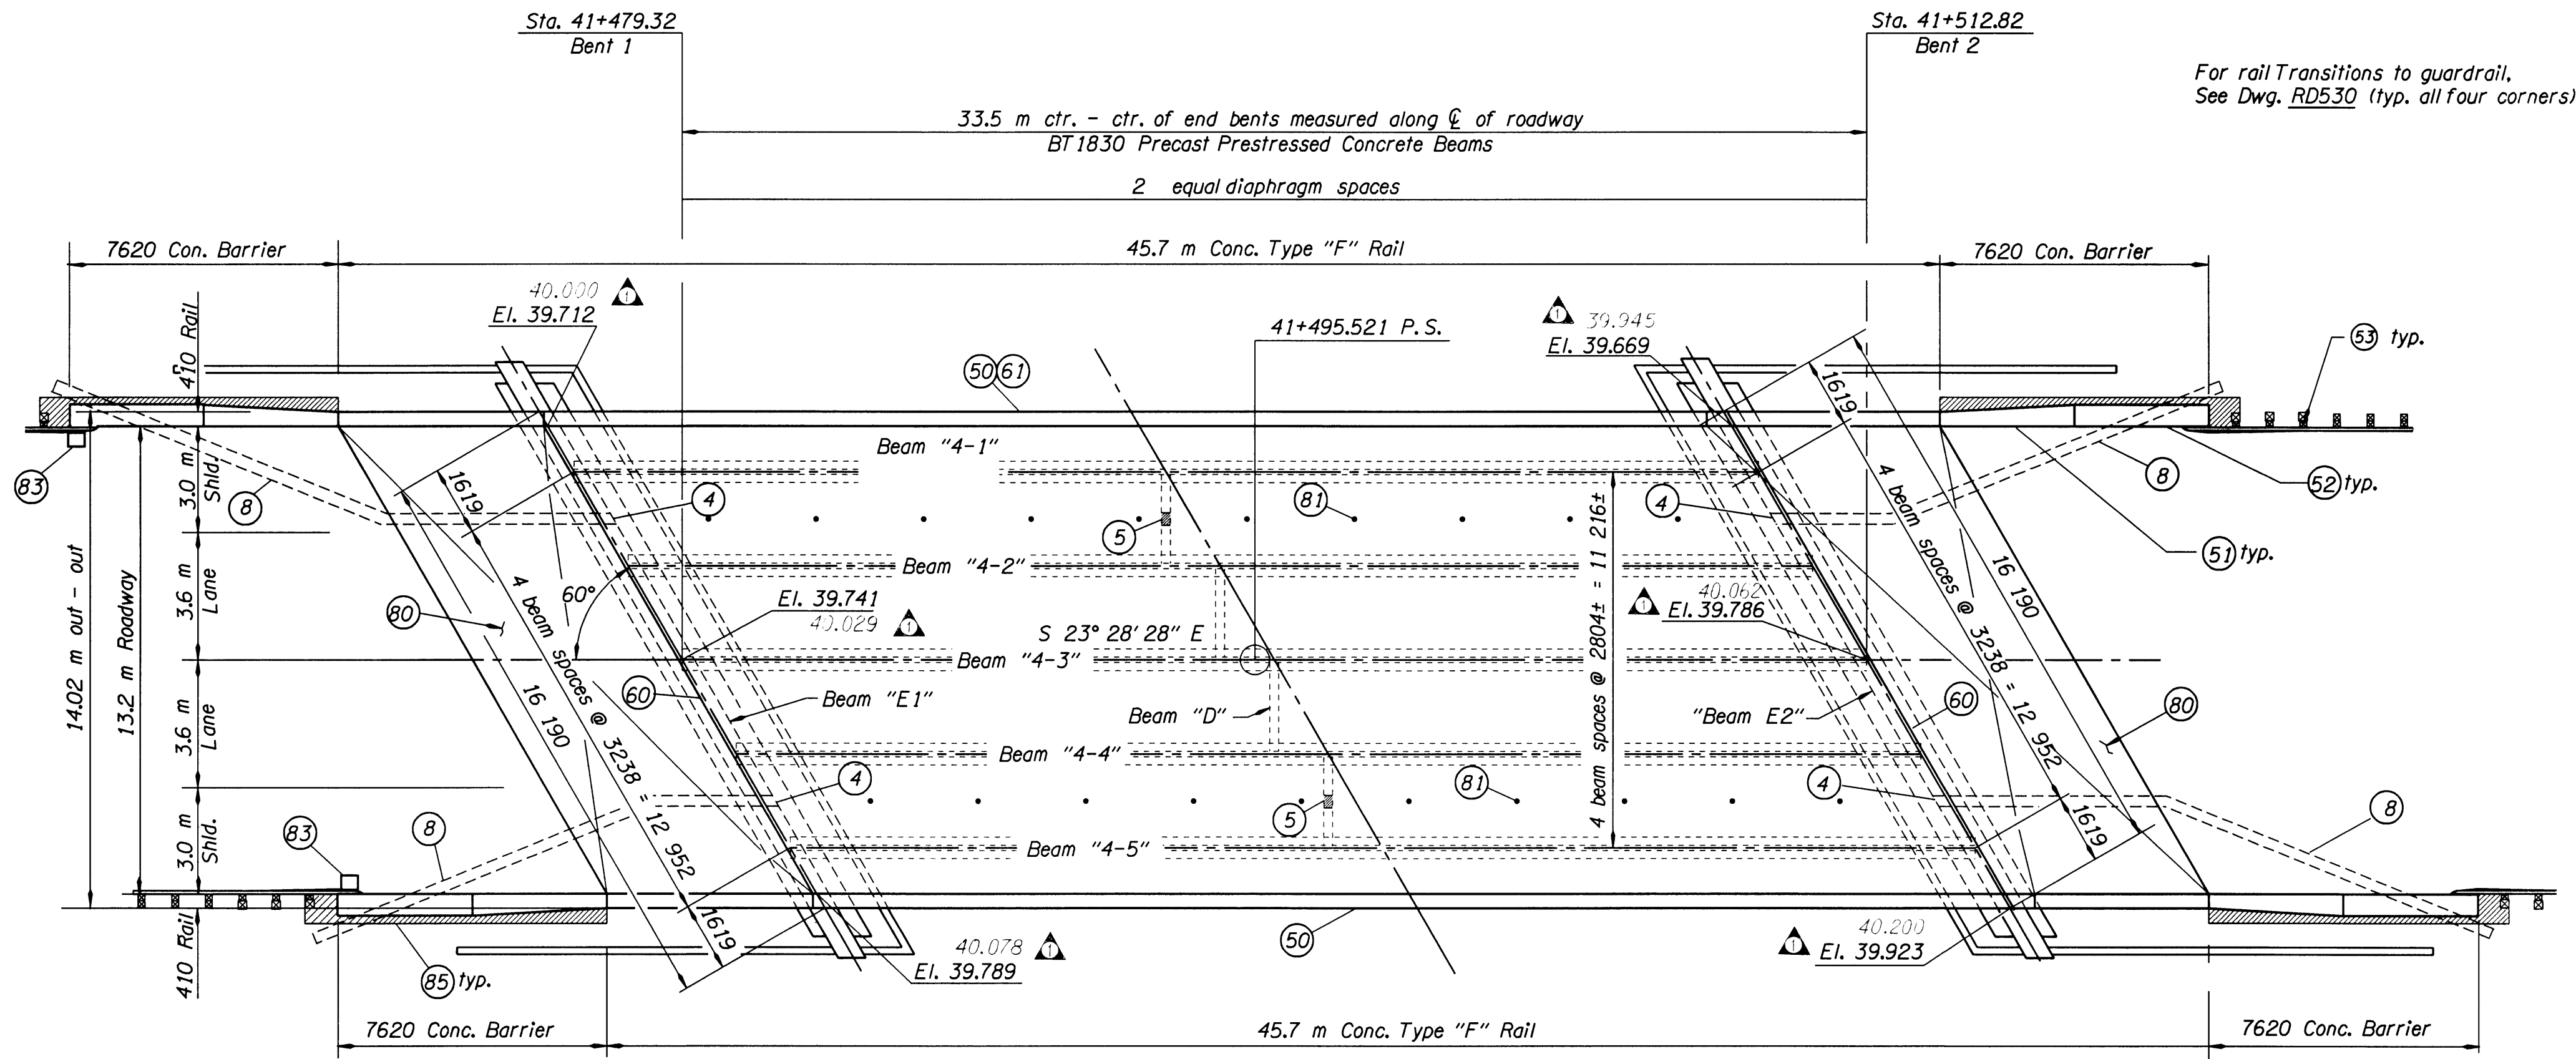


For rail Transitions to guardrail,
See Dwg. RD530 (typ. all four corners)

DETAIL REFERENCE NOTES





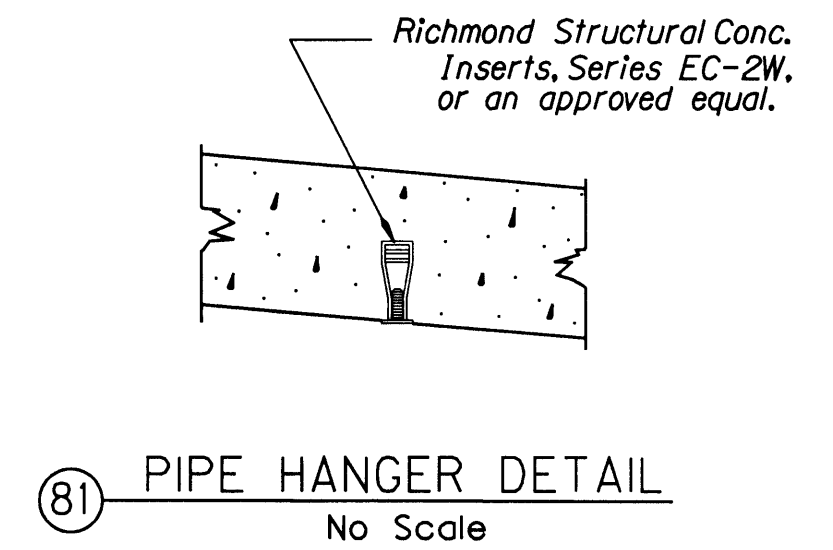


- (4) 350 mm dia. utility hole through beam "E1" and "E2".
- (5) 350 mm dia. utility hole through beam "D".
- (8) Place 305 mm I.D. concrete culvert pipe or a 324 mm O.D. galv. smooth steel pipe (6.35 mm wall thickness) at each utility hole. Extend pipe from end beam (backwall) under Reinforced Concrete End Panel to the end of the adjacent MSE wall. Elbow pipe to Shoulder area as shown on Plan. Install pipe 50 mm into oversized formed hole in end beam (backwall) (hole to be 30 mm larger than pipe O.D.) Fill void around pipe with a compressible material after installation. Cap Pipe End.
- (50) Standard Type "F" Concrete Bridge Rail, See Dwg. BR200.



- (51) For Cast In Place Concrete Barrier Transition to Bridge Rail See Dwg. RD520. (Typ. all four corners)
- (52) For Precast Concrete Barrier See Dwg. RD500. (Typ. all four corners)
- (53) For Rail Connection to guardrail. See Dwg. RD530. (Typ. all four corners)
- (60) Deck Rotational Joint, see dwg. 55479 for details.
- (61) Place 6 mm preformed expansion joint material thru. concrete at 4.6 m max. ctrs. See Dwg. BR200 for details.
- (80) 6.1 m Reinforced Concrete End Panel (typ. ea. end) see dwg. 55479 for details.
- (81) Place Richmond structural concrete inserts EC-2W or an approved equal for M19 bolts in bottom of deck at 3.0 m max. ctrs. over each utility hole (inserts shall be hot dipped galvanized).
- (83) Type G-2 inlet, see dwg. RD336. for pipe installation detail, see grading plans.
- (85) Paved surface. See Shoulder Barrier Detail Dwg. 55477

PLAN
Scale: 1:100




NOTE: All stations and elevations are in meters. All other dimensions are in millimeters (mm) except as noted.

	DATE	REVISION	BY	DRAFTED: 		 OREGON DEPARTMENT OF TRANSPORTATION BRIDGE ENGINEERING SECTION	BRIDGE NO.	LITTLE ELK CREEK BRIDGE NO. 4	SHEET
	10-16-07	As Constructed	JAM	CHECKED: 			18049		5
				DESIGNED: 			DATE		OF
							08-JUL-1997		18
							CALC. BOOK	DECK PLAN	DRAWING NO.
							4590		55372

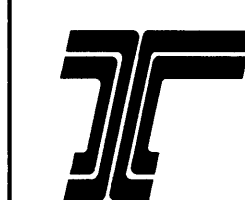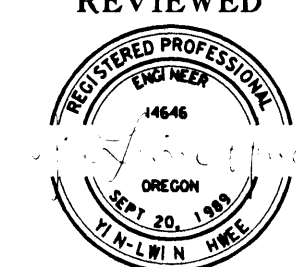

NT 7460c(j11):C:\USR\BR\PROJECTS\00798\C18049.DGN 08-JUL-1997 [VIEW=D3] [PGRID=D3]

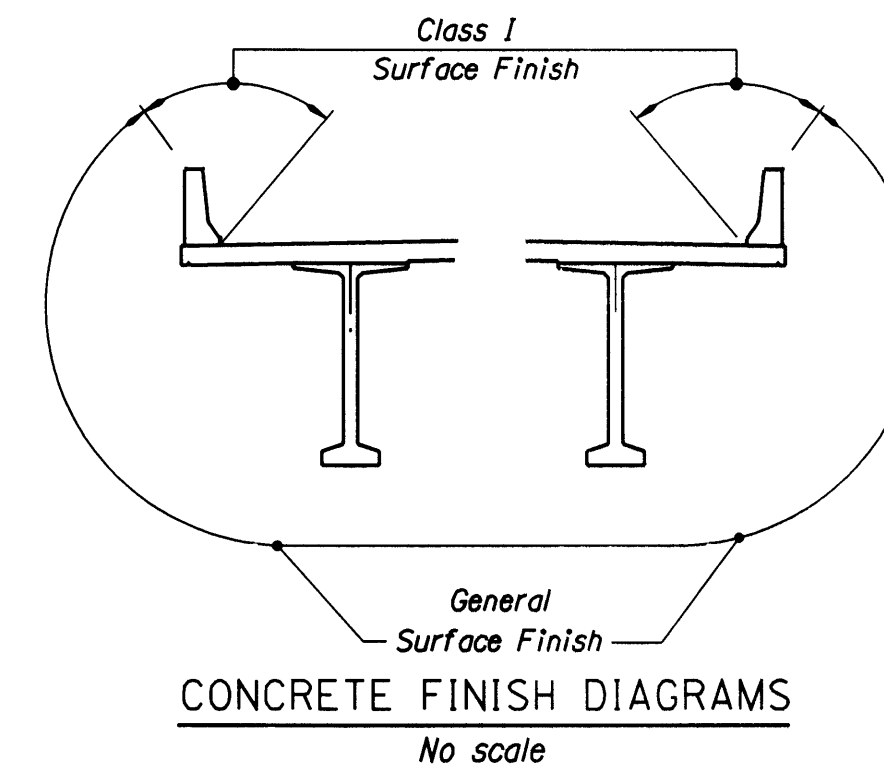

The elevation view shows the roof profile with a central horizontal section and two sloped sections on either side. The central section is labeled with a length of 2194. The sloped sections are labeled with a length of 190. The roof height is indicated as 75 on both sides. Below the roof profile, a horizontal line represents the location of Bars "C".

The diagram shows a trapezoidal cross-section divided into three regions: "B" (left), "A" (center), and "B" (right). The left and right regions are shaded with vertical lines. The top surface is sloped, and the bottom surface is horizontal. Dimensions of 1.0 m are indicated for the sloped sections.

250

50 cl.

50 cl.

Add 4-#16 x cont. bars over Bm. "D"

205 deck

95 cl.

between beams

#16 bars "A" at 300

#16 bars "B" at 300

50 threaded (4.6) at beam

2390 ea. face

bent bars "C"

1738 0-0 #16 stirrups

50 cl.

Diagram illustrating the geometry of Bars A and B:

- Bar A:** A U-shaped bar with a vertical stem of length 1738 and two horizontal top flanges of length 155 each. The base width is 150.
- Bar B:** A rectangular bar with a height of 150 and a width of 150. The vertical dimension is labeled "varies".

Longitudinal bars:

54-#16 x cont. @ 300 mm max. (Top of deck) epoxy coated in Area "A".
108-#16 x cont. @ 150 mm max. (Top of deck) epoxy coated in Area "B".
48-#16 x cont. @ 300 mm max. (bottom of deck) in Area "A".
96-#16 x cont. @ 300 mm max. (bottom of deck) in Area "B".
Place all longitudinal bars parallel to & Roadway.

Transverse bars:


*16 bars x cont. @ 300 mm max. full length of structure
(top and bottom) Top bars epoxy coated in Area "A".

*16 bars x cont. @ 150 mm max. full length of structure
(top and bottom) Top bars epoxy coated in Area "B".

See Deck Steel Placement Diagram.

Stop all transverse bars 150 mm clear of transverse beams.

NOTE: All stations and elevations are in meters. All other dimensions are in millimeters (mm) except as noted.

	DATE	REVISION	BY	<div>DRAFTED:  Jeffrey Lannigan</div> <div>CHECKED:  Nowzar Ardalan</div> <div>DESIGNED:  Nam Bui</div>	<div>REVIEWED</div> <div></div> <div>EXPIRES: 6/30/99</div>	<div> OREGON DEPARTMENT OF TRANSPORTATION</div> <div>BRIDGE ENGINEERING SECTION</div>	BRIDGE NO.	LITTLE ELK CREEK BRIDGE NO. 4	SHEET
	10-16-07	As Constructed	JAM				18049		6
							DATE		OF
							08-JUL-1997		18
							CALC. BOOK		DRAWING NO.
				4590				TYPICAL DECK SECTION	55373