
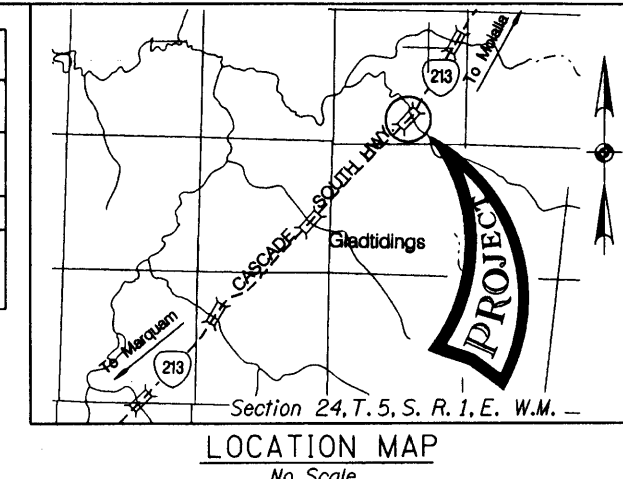


| HYDRAULIC DATA | | | | |
|--|---------------------|--------------|------------|---------------------|
| ITEMS | (UNITS) | DESIGN FLOOD | BASE FLOOD | MAX. PROBABLE FLOOD |
| DISCHARGE | (m ³ /s) | 51.8 | 60.2 | 79.3 |
| FREQUENCY | (YRS.) | 50 | 100 | 500 |
| H.W. ELEV. AT UPSTREAM FACE OF BRIDGE ALONG EMBANKMENT | (m) | 53.90 | 54.04 | 54.27 |

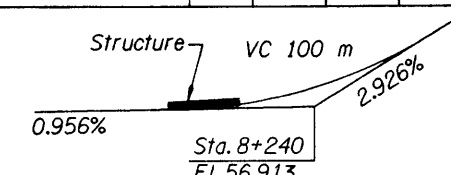

General Notes:
 All material and workmanship shall conform to the 1996 Standard Specifications for Highway Construction of the Oregon Department of Transportation.
 Bridge is designed for MS22.5 loading with an allowance of 1.20 KN/m² for future wearing surface.
 Concrete deck is designed using the empirical method for isotropic reinforcing of the Ontario Highway Bridge Design Code.
 Concrete members (except prestressed members) are designed by Load Factor Design Method.
 Seismic design is in accordance with the AASHTO Division 1-A, "Seismic Design" Standard Specifications for Seismic Design of Highway Bridges. The site bedrock acceleration coefficient (A) is 0.17g and the assumed soil response coefficient is 1.0.

All piling shall be PP 325 x 9.5, ASTM A252, Grade 3 driven open ended to an ultimate capacity of 2915 KN per pile.
 Pile tip elevation for minimum pile penetration at Bent 1 shall be elevation 45.7.
 Pile tip elevation for minimum pile penetration at Bent 2 shall be elevation 46.9.
 All piling shall be driven to the specified ultimate capacity using driving criteria developed from the ODOT Gates Equation.
 All reinforcing steel shall conform to ASTM Specification A706M, or AASHTO M31/M (ASTM A615) Grade 420 N/mm².
 Field bent stirrups shall conform to ASTM Specification A706M. The following splice lengths shall be used unless shown otherwise:

| Bar Size | 10 | 13 | 16 | 19 | 22 | 25 | 29 | 32 | 36 | 43 | 57 |
|--------------------|-----|-----|-----|-----|------|------|------|------|------|---------------|---------------|
| Splice Length (mm) | 300 | 400 | 500 | 600 | 850 | 1075 | 1400 | 1750 | 2150 | Not Permitted | Not Permitted |
| Epoxy Coated | 425 | 550 | 700 | 850 | 1175 | 1525 | 1925 | 2450 | 3000 | Not Permitted | Not Permitted |

Splice reinforcing steel at alternate locations, staggering as far as possible, unless shown otherwise.
 Epoxy coat reinforcing steel in the upper portion of the deck and bridge end panels. This includes top longitudinal bars, and top transverse bars and all bars extending from the Bridge Deck or End Panels into the parapets.
 Place bars 50mm clear of the nearest face of concrete (unless shown otherwise). The top bends of stirrups extending from prestressed precast units may be shop or field bent (unless shown otherwise).
 Do not fabricate reinforcing steel for abutments and wingwalls until final elevations have been determined in the field.
 Concrete in precast prestressed beams shall be 40 - 19.
 Concrete in reinforced concrete end panels and deck shall be Class 30 - 19.
 All other concrete shall be Class 25 - 37.5 or 19.
 Prestressing steel shall be in accordance with detail plans.
 Bore hole and place PP 610 x 12.70. Settlement of placed piles shall be negligible.

NOTE: All dimensions are in millimeters (mm) except as noted.

| DATE | REVISION | BY |
|------------|------------------------------|------|
| 8-13-97 | No driven piles, Bore holes. | H.S. |
| 10-11-2001 | As Constructed. | PKT |

DESIGNER
Ann Durley
 CHECKED:
 REVIEWED: Mark Hirota

DESIGNER
Homer Sordy
 EXPIRES: 6-30-98

BRIDGE ENGINEER
 EXPIRES: 6-30-98


OREGON DEPARTMENT OF TRANSPORTATION
 BRIDGE ENGINEERING SECTION
 ACCOMPANIED BY DWGS. 54204 thru 54211, 54616
 BR200, BR203 and BR350

BRIDGE NO.
18277
 DATE
18-FEB-1997
 CALC. BOOK
4561

ROCK CREEK BRIDGE
 ROCK CREEK BRIDGE SECTION
 CASCADE HIGHWAY (M.P. 18.66)
 CLACKAMAS COUNTY
 PLAN and ELEVATION
 FEDERAL HIGHWAY ADMINISTRATION
 REGION 10 OREGON DIVISION
 PROJECT NUMBER

SHEET
1
OF
13
 DRAWING NO.
54203

Project Manager: Ron Clay

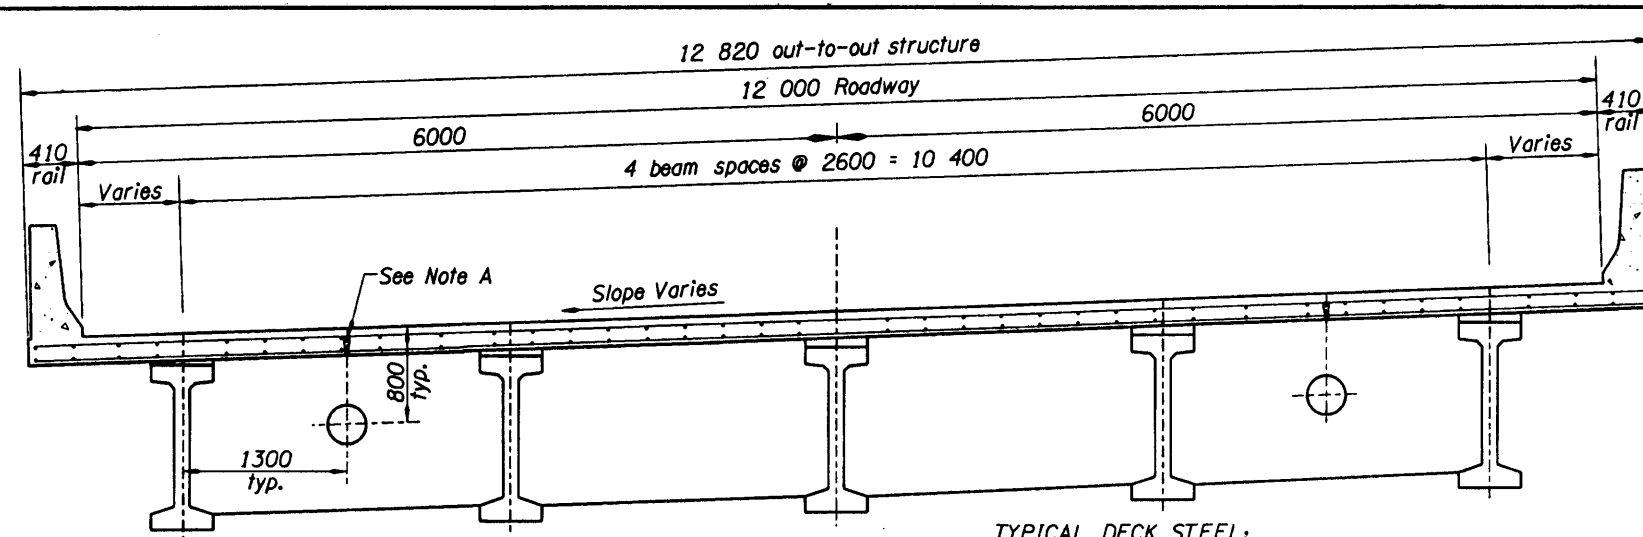

Note A:
Hot dipped galvanized Richmond Structural Concrete Inserts, Series EC-2F, or an approved equal for 19 dia. threaded rods. Place in bottom of deck @ 3000 max. ctrs. full length of deck in each exterior bay and in overhang as shown. (For utility installations not immediately used, install sort galvanized bolts in insert).

TYPICAL DECK SECTION

No Scale

POUR SCHEDULE:

1. Pour diaphragm Bem-D.
2. Pour deck to within 1 m of the centerline of the end bents.
3. Pour end bents.
4. Pour remainder of deck.

TYPICAL DECK STEEL:

Longitudinal Bars:

Bars "c" - #16 L-bars 2500 @ 150 max. ctrs. w/1000 legs
(top bars epoxy coated) place at end bents

*16 bars x cont. @ 300 max. ctrs. (top of deck) epoxy coated.

*16 bars x cont. @ 300 max. ctrs. (bottom of deck)

Place all longitudinal bars parallel to beams.

Transverse Bars:


Bars "a" - #16 bars x varies @ 300 max. ctrs. w/600 legs (top and bottom)

Bars "b" - #16 bars x cont. @ 300 max. ctrs. (top and bottom)

Top bars epoxy coated.


Place all transverse bars perpendicular to C roadway.

Bottom mat reinforcing steel shall be supported from the forms with precast mortar blocks at 914 ctrs. (max.) each way. Top mat reinforcing steel shall be supported from the bottom mat reinforcing steel with reinforcing bar supports by Dayton Superior Co. (SBU, BBU or CHCU). Richmond (SBU, BBU or CHCU) or on approved equal, at 914 ctr. (max.).

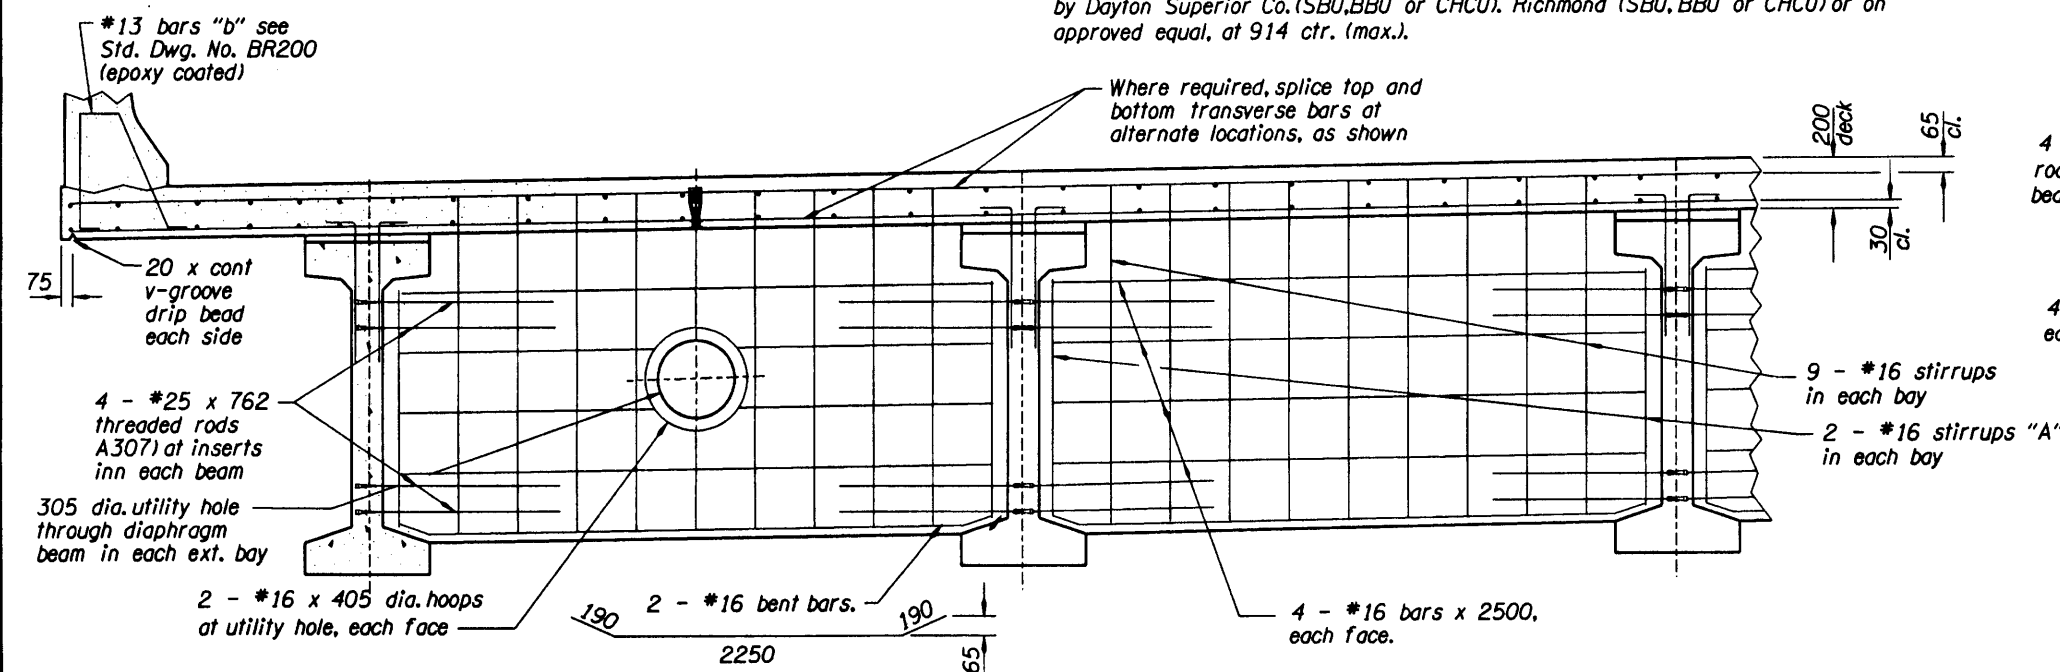


DIAPHRAGM BEAM-D DETAIL

No Scale

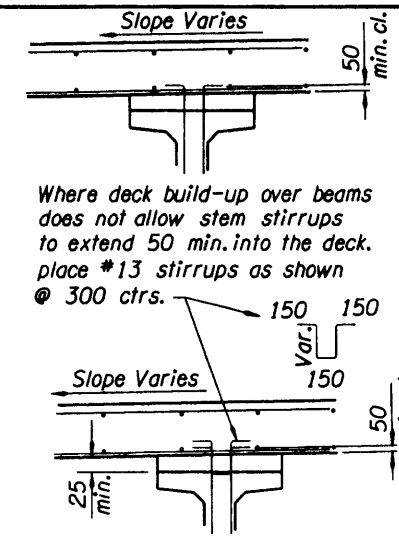


SECTION A-A

No Scale

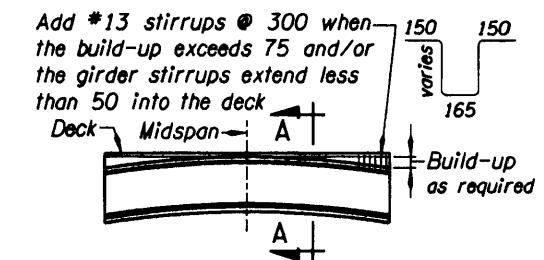

Beam soffits shall be on level grade prior to prestressing. Difference between deck elevation and camber in beams shall be compensated for by build-up over beams.

BUILD - UP DECK DETAIL

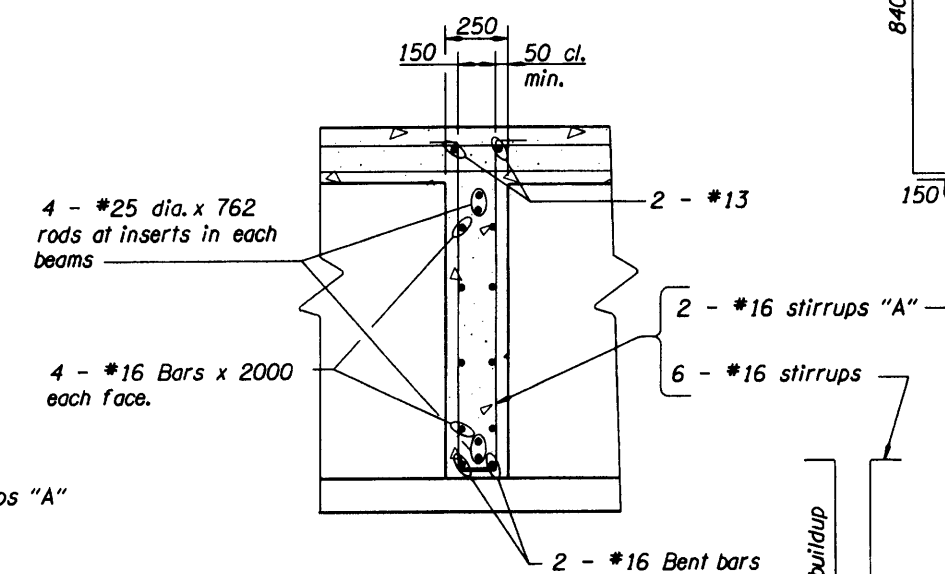

TYPICAL SECTION
DIAPHRAGM BEAM-D


No Scale

NOTE: All dimensions are in millimeters (mm) except as noted.


| △ | DATE | REVISION | BY |
|---|------------|-----------------|-----|
| | 10-11-2001 | As Constructed. | pat |
| | | | |
| | | | |
| | | | |
| | | | |

DRAFTED: John Ott

CHECKED: _____

REVIEWED:  Mark Hirota

DESIGNER

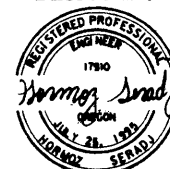

EXPIRES: 6-30-98



**OREGON DEPARTMENT OF TRANSPORTATION
BRIDGE ENGINEERING SECTION**

| | |
|---|---------------------|
| N | BRIDGE NO. 18277 |
| | DATE 19-FEB-1997 |
| | CALC. BOOK 4561 |

ROCK CREEK BRIDGE

TYPICAL DECK SECTION AND DETAILS



METRIC

SHEET
5
OF
13

DRAWING NO. 4


54207 133

19-FEB-1997


VIEW=F3] [PGRID=F3]

C:\USR\BRV\PROJECTS\0702\N\18277r.dgn

br2020f:

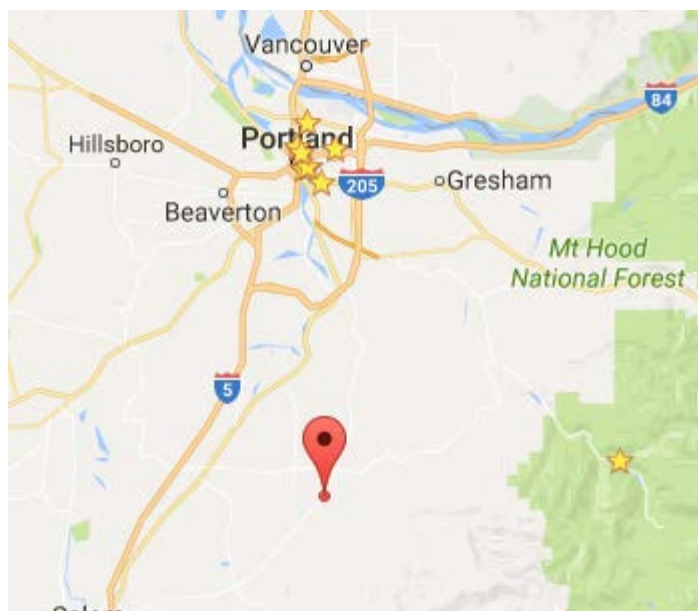

45.11741, -122.62826

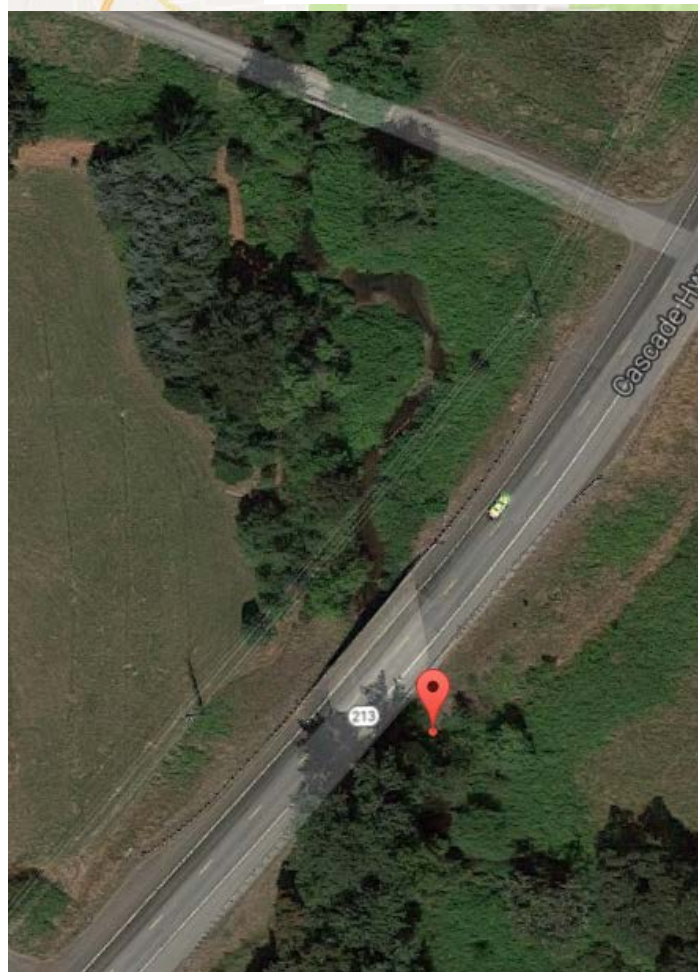

36 min (23.4 miles)



via OR-213 N

33 min without traffic

Comfort Inn & Suites

1775 Freeway Court Northeast, Salem, OR 97301

↑ Head north on Fwy Ct NE toward Hawthorne Ave NE
302 ft

➤ Turn right onto Hawthorne Ave NE
1.1 mi

➤ Turn right onto Silverton Rd NE
10.4 mi

↑ Continue onto OR-213 N
0.8 mi

↶ Turn left onto N 1st St/Cascade Hwy NE
230 ft

➤ Turn right at the 1st cross street onto OR-213 N/Oak St

[i](#) Continue to follow OR-213 N

[i](#) Destination will be on the right

11.0 mi

Rock Creek

Time to hotel: 5.5 hours
(including stop at PDX)

Comfort Inn & Suites

1775 Freeway Ct Northeast
Salem, OR 97301

+1 503-588-0515

Holiday Inn Express Pendleton

600 SE Nye Ave, Pendleton, OR 97801
(541) 966-6520

18277 160 01866

Bridge 2 - Oregon

[Portal Link](#)

NBI data

1 - State Name

8 - Structure Number

Bridge Name

26 - Functional Class Of Inventory Rte.

48 - Length Of Largest Span

49 - Total Length

52 - Deck Width

34 - Skew

22 - Owner

27 - Year Built

37 - Historic Significance

31 - Design Load

45 - Number Of Main Spans

43A - Main Span Materials

43B - Main Span Design

107 - Deck Type

108A - Wearing Surface

Oregon

18277 160 01866

OR 213 (HWY 160) over ROCK CREEK

6 - Rural Minor Arterial

21

21

12.8

45

1 - State Highway Agency

1997

5 - Bridge is not eligible for the NRHP.

9 - MS 22.5 / HS 25

1

5 - Prestressed concrete

2 - Stringer/Multi-beam or girder

1 - Concrete Cast-in-Place

1 - Monolithic Concrete (concurrently placed
with structural